

3 BHK + DSQ APARTMENTS

RARE OPEN VIEW

2300 sq.ft. / 213.75 mtr.sq.

APARTMENT NO. LEVEL

FLOOR ~~SECOND~~ 2L
FLOOR ~~THIRD~~ 3L
FLOOR ~~FOURTH~~ 4L

FLOOR ~~SIXTH~~ 6L
FLOOR ~~SEVENTH~~ 7L
FLOOR ~~EIGHTH~~ 8L
FLOOR ~~NINTH~~ 9L


FLOOR ~~ELEVENTH~~ 11L
FLOOR ~~TWELFTH~~ 12L
FLOOR ~~FOURTEENTH~~ 14L

APARTMENT NO. LEVEL

FLOOR ~~SECOND~~ 2S
FLOOR ~~THIRD~~ 3S
FLOOR ~~FOURTH~~ 4S

FLOOR ~~SIXTH~~ 6S
FLOOR ~~SEVENTH~~ 7S
FLOOR ~~EIGHTH~~ 8S
FLOOR ~~NINTH~~ 9S

FLOOR ~~ELEVENTH~~ 11S
FLOOR ~~TWELFTH~~ 12S
FLOOR ~~FOURTEENTH~~ 14S

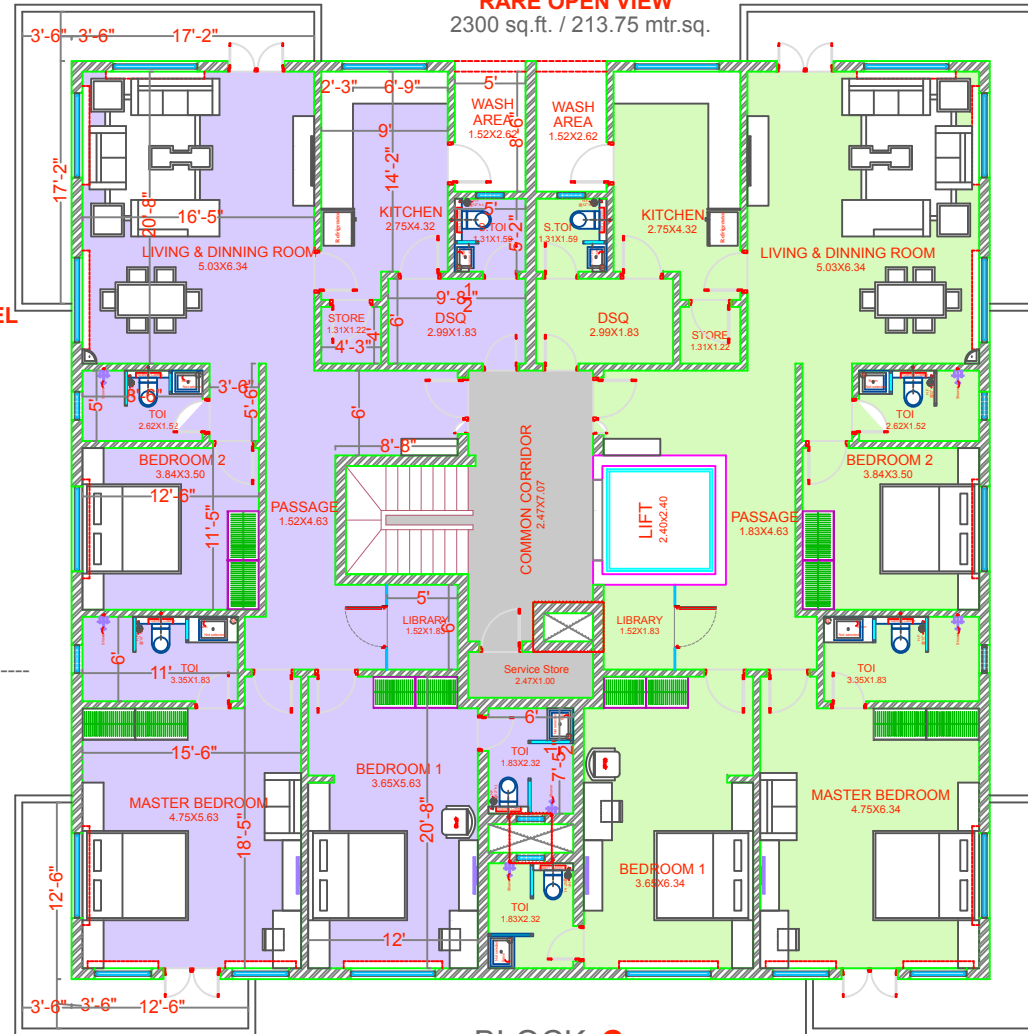

BLOCK - C 25 APARTMENTS TOWER

NOTES

1. This drawing is a copy right & property of the Architect/Interior Designer, is not to be produced, copied, handed over to third party or used for any other purpose other than for which it is intended.
2. All dimensions shall be verified on site prior to start of work discrepancy shall be brought to the notice of the Architect.
3. Carpet area of Typical Floor Plan Apartment 2000 sq.ft. (Super built up 2300 sq.ft.)
4. This drawing is to be read & not scaled.
5. This drawing should be read in conjunction with relevant working & detailed drawings.

PROPOSED RESIDENTIAL LAYOUT PLAN AT NAIROBI

SCALE: N.T.S. DRG. NO. 03
DATE: 14 Nov. 17
CHECKED BY: HATIM

PROJECT :- AZALEA HEIGHTS

GENERAL MATHENGE ROAD
NAIROBI KENYA
MO. NO :- VIN - +254-705791702 ; HUZEFA - +254-780447447



FAIRDEAL PROPERTIES

Development and Infrastructure
3rd Floor Fairdeal Plaza, MSA-MLD ROAD
P.O.BOX 81911-80100
www.fairdealproperties.biz

Designed By: -

Ar. Hatim Badshah